


5185 MACARTHUR BOULEVARD, NW

Washington, DC

TRANSWESTERN

RETAIL

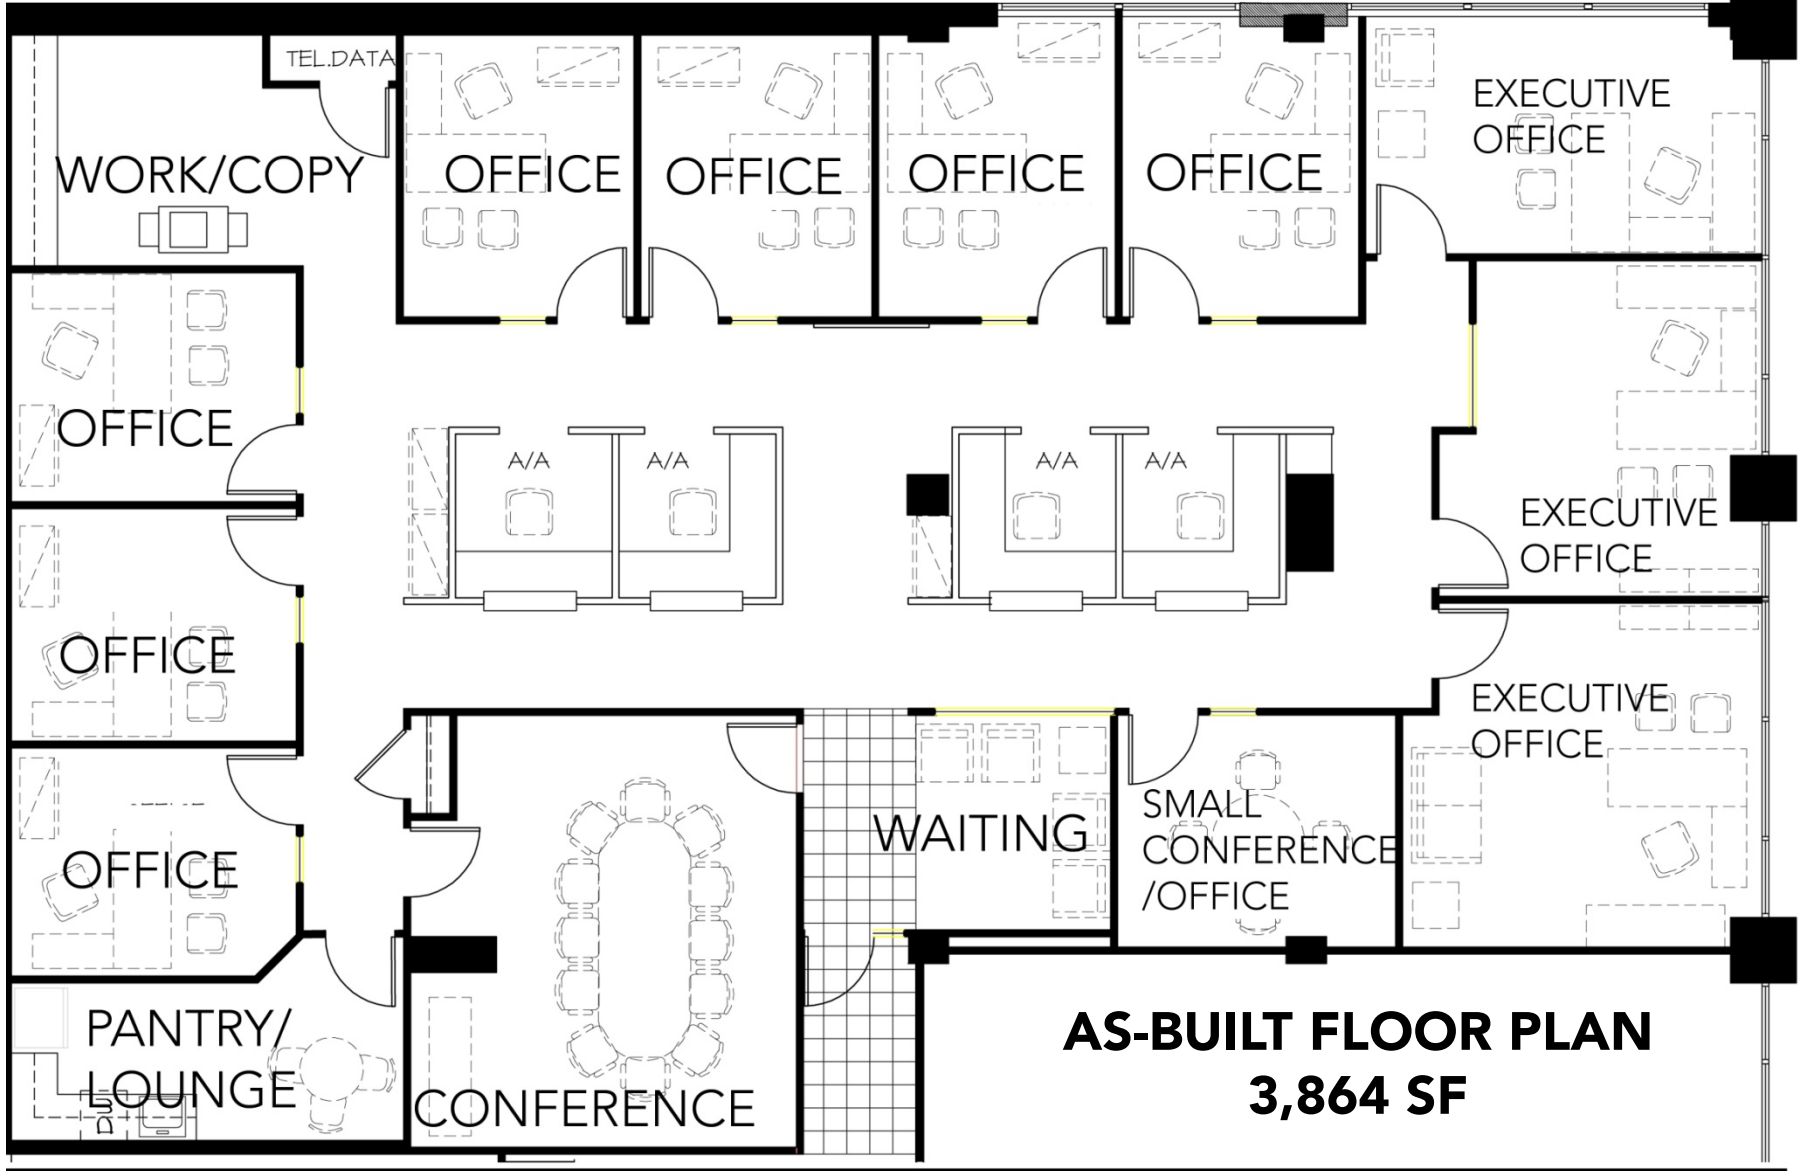

**AS-BUILT FLOOR PLAN**  
**3,864 SF**